

ORDER RECEIVED FOR FILING

Date

By

IN RE: PETITION FOR SPECIAL HEARING * BEFORE THE
of Dogwood Road at * DEPUTY ZONING COMMISSIONER
Edwards Avenue * OF BALTIMORE COUNTY
(Windsor Corporate Park) * Case No. 90-226-SPH
2nd Election District
2nd Councilmanic District
Leroy M. Merritt
Petitioner

FINDINGS OF FACT AND CONCLUSIONS OF LAW

The Petitioner herein requests a special hearing to approve a use permit for business parking in a residential zone as more particularly described in Petitioner's Exhibit 1.

The Petitioner, by Randy Warren, Project Manager, appeared, testified and was represented by Robert A. Hoffman, Esquire. Also appearing on behalf of the Petitioner was Pat Cialo with George W. Stephens, Jr. and Associates, Inc., and Bill Kirwin, Landscape Architect. Appearing as interested parties were Ferdinand and Rabeth Eitemiller. Mrs. Eitemiller and her mother own property adjacent to one of the areas proposed for business parking in the D.R. zone.

Testimony indicated that the subject property, known as Windsor Corporate Park, consists of 82.55 acres, split zoned M.L., M.L.-I.M., M.L.R., M.L.R.-I.M., D.R. 5.5 and D.R. 3.5, and is located off of Rolling Road between Botanicus Road and Dogwood Road. The majority of the site is zoned M.L. while approximately 19 acres more or less are zoned D.R. 3.5 and D.R. 5.5. Said property received CRG approval for development as warehouse and office uses. Petitioner is requesting a use permit to place an additional 202 parking spaces on 1.37 acres more or less of the D.R. 3.5 zoned portion of the property as depicted in the shaded areas on Petitioner's Exhibit 1B. Mr. Warren testified that there is currently adequate

parking on the site for approximately 27% of those buildings used for office space without using any portion of the D.R. zones. As a result of market studies done and adjoining uses, a determination was made that it would be beneficial to increase the percentage of office space to approximately 37% of the proposed square footage for the site. However, to do so would require additional parking thereby necessitating Petitioner's request.

Testimony presented by Mr. Kirwin indicated that the Petitioner proposes to landscape the property in the areas of the requested relief to prevent any detrimental impact of the proposed use on the adjoining residential uses. Petitioner submitted a preliminary landscaping plan Petitioner's Exhibits 2A and 2B. A complete landscaping plan will be prepared and submitted to the Baltimore County Landscape Planner for approval. Mr. Kirwin and Mr. Warren testified the relief requested meets the conditions set forth in Section 409.8b of the Baltimore County Zoning Regulations (B.C.Z.R.). Further testimony indicated that the use proposed meets the conditions required by Section 502.1 of the B.C.Z.R.

Mr. & Mrs. Eitemiller testified that they were in favor of permitting the lighting of the parking areas to extend beyond normal business hours as they agreed with Petitioner that continuous lighting of the parking lots at night is beneficial from a security standpoint for both the buildings on the subject site and adjoining residential properties.

Petitioner seeks relief from Section 409.8, pursuant to Sections 507 and 502.1 of the B.C.Z.R.

It is clear from the testimony that the use of the terms "use permit" and "special exception" are intended to be interchangeable and the import of either is the same. See Hofmeister v. Frank Realty Co., 373

A.2d 273 (1977). The request for a use permit under Section 409.4 is in reality a request for a special exception. Therefore, in order for a use permit to be approved, the property owner must satisfy the burden of proof required by Section 502.1.

It is also clear that the B.C.Z.R. permits the use proposed in a D.R. zone by special exception. Further, it is clear that the proposed use would not be detrimental to the primary uses in the vicinity. Therefore, it must be determined if the conditions as delineated in Section 502.1 are satisfied.

The Petitioner had the burden of adducing testimony and evidence which would show that the proposed use met the prescribed standards and requirements set forth in Section 502.1 of the B.C.Z.R. The Petitioner has shown that the proposed use would be conducted without real detriment to the neighborhood and would not adversely affect the public interest. The facts and circumstances do not show that the proposed use at the particular location described by Petitioner's Exhibit 1 would have any adverse impact above and beyond that inherently associated with such a special exception use, irrespective of its location within the zone. Schultz v. Pritts, 432 A.2d 1319 (1981).

The proposed use will not be detrimental to the health, safety, or general welfare of the locality, nor tend to create congestion in roads, streets, or alleys therein, nor be inconsistent with the purposes of the property's zoning classification, nor in any other way be inconsistent with the spirit and intent of the B.C.Z.R.

After reviewing all of the testimony and evidence presented, it appears that the relief requested in the special hearing should be granted with certain restrictions as more fully described below.

- 2 -

Pursuant to the advertisement, posting of the property, and public hearing on this Petition held, and for the reasons given above, the relief requested in the special hearing should be granted.

THEREFORE, IT IS ORDERED by the Deputy Zoning Commissioner for Baltimore County this 28th day of December, 1989 that the Petition for Special Hearing to approve a use permit for business parking in a residential zone, in accordance with Petitioner's Exhibit 1, be and is hereby GRANTED, subject, however, to the following restrictions which are conditions precedent to the relief granted:

1) The Petitioner may apply for a permit and be granted same upon receipt of this Order. Petitioner is hereby made to proceed at this time is at his own risk until such time as the 30-day appeal period from this Order has expired. If, for whatever reason, this Order is reversed, the Petitioner would be required to return, and be responsible for returning, said property to its original condition.

2) All lighting for the parking areas shall be erected in such a manner so as not to deflect into adjacent residential areas.

3) A complete landscape plan shall be submitted for approval by the Baltimore County Landscape Planner. Said plan shall provide screening and landscaping in a minimum as set forth in Petitioner's Exhibits 2A and 2B to provide adequate buffering of adjacent residential areas. Additional landscaping may be required by the Landscape Planner. The landscaping required shall be maintained at all times.

4) Only passenger vehicles, excluding buses, may use the parking areas in the residential zones. No loading, service or any use other than parking shall be permitted in the D.R. zones.

5) Prior to the issuance of any permits, a satisfactory plan clearly depicting the parking arrangements and vehicular access in the D.R. zones shall be submitted to the Zoning Commissioner's Office for approval.

- 4 -

84

PETITION FOR SPECIAL HEARING
TO THE ZONING COMMISSIONER OF BALTIMORE COUNTY: 90-226-SPH

The undersigned, legal owner(s) of the property situated in Baltimore County and which is described in the petition and plat attached hereto and made a part hereof, hereby petition for a Special Hearing under Section 500.7 of the Baltimore County Zoning Regulations, to determine whether or not the Zoning Commissioner and/or Deputy Zoning Commissioner should approve _____ a use permit for parking in a residential zone pursuant to Section 409.8 of the Baltimore County Zoning Regulations.

Property is to be posted and advertised as prescribed by Zoning Regulations. I, or we, agree to pay expenses of the above Special Hearing advertising, posting, etc., upon filing of this Petition, and further agree to be bound by the zoning regulations and restrictions of Baltimore County adopted pursuant to the Zoning Law for Baltimore County.

I/we do solemnly declare and affirm, under the penalties of perjury, that I/we are the legal owner(s) of the property which is the subject of this Petition.

Contract Purchaser:	MAP <u>INV 16</u> <u>F 2</u> (Type or Print Name)
Signature	<u>Leroy M. Merritt</u> Signature
Address	<u>210 Allegheny Avenue</u> <u>Towson, MD 21204</u>
City and State	<u>Towson, MD</u>
Attorney for Petitioner:	2066 Lord Baltimore Drive, 238-B Phone No. <u>823-4111</u> Name <u>John B. Howard</u> Address <u>210 Allegheny Avenue</u> City and State <u>Towson, MD 21204</u> Attorney's Telephone No. <u>823-4111</u> Phone No. <u>823-4111</u>

ORDERED By the Zoning Commissioner of Baltimore County, this Sept. 29, 1989, that the subject matter of this petition be advertised, as required by the Zoning Law of Baltimore County, in two newspapers of general circulation throughout Baltimore County, that property be posted, and that the public hearing be held before the Zoning Commissioner of Baltimore County in Room 108, County Office Building, in Towson, Baltimore County, the 13 day of Dec. 1989, at 9:30 o'clock A.M.

FILED BY J. Robert Haines 9/30/89
AND SAME DAY
CHARGED TIME 2 HRS +
THE USE PERMIT WAS CHALLENGED
(COUNCILMANIC ASSOC.) (per)
OPPOSITION

J. Robert Haines
Zoning Commissioner of Baltimore County

FROM THE OFFICE OF
GEORGE WILLIAM STEPHENS, JR., & ASSOCIATES, INC.
ENGINEERS
P.O. BOX 622, TOWSON, MARYLAND 21204

84
90-226-SHP

Description to Accompany a
Petition for a Special Hearing
RE: Windsor Corporate Park

August 18, 1989

Parking Parcel A
Point of beginning being located North 63 degrees 00 minutes 48 seconds West 31.83 feet +/- from the point of intersection of the centerlines of Dogwood Road and Edwards Avenue, thence running in a clockwise direction:

- 1) Due West 90.00 feet +/-,
- 2) Due North 113.00 feet +/-,
- 3) Due East 17.97 feet +/-,
- 4) South 83 degrees 29 minutes 33 seconds East 73.47 feet +/- and
- 5) Due South 104.67 feet +/- to the place of beginning.

Containing 0.226 acres of land more or less.

Parking Parcel B
Point of beginning being located North 45 degrees 59 minutes 38 seconds West 914.40 feet +/- from the point of intersection of the centerlines of Dogwood Road and Edwards Avenue, thence running in a clockwise direction:

- 1) South 87 degrees 24 minutes 42 seconds West 68.44 feet +/-,
- 2) North 05 degrees 27 minutes 20 seconds West 280.00 feet +/-,
- 3) South 83 degrees 08 minutes 14 seconds West 271.60 feet +/-,
- 4) South 83 degrees 31 minutes 05 seconds West 243.15 feet +/-,
- 5) South 05 degrees 43 minutes 18 seconds West 251.69 feet +/-,
- 6) North 05 degrees 43 seconds 00 minutes West 95.74 feet +/-,
- 7) North 85 degrees 38 minutes 14 seconds East 824.48 feet +/- and
- 8) South 02 degrees 35 minutes 18 seconds East 350.98 feet +/- to the place of beginning.

Containing 2.073 acres of land more or less.

(NOTE: THE ABOVE DESCRIPTIONS ARE FOR ZONING PURPOSES ONLY AND NOT TO BE USED FOR LAND CONVEYANCES OR AGREEMENTS.)



HEARING FILE
90-226-SH
26.90-226-SHP

BALTIMORE COUNTY, MARYLAND

INTER-OFFICE CORRESPONDENCE

TO: Al Wirth - SWD
Bob Bowling - Dev. Eng.
Frank Fisher - Current Planning
Bill - Traffic Engineering
Larry Wilson - DEPRM
Dave Flowers - Critical Areas
Carl Richards - Zoning
Capt. Kelly - Fire Department
Pat Kincer - Rec. & Parks
Larry Brocato - SHA
Rocky Powell - EIRS
Peter A. Paff
Bureau of Public Services

DATE: 11/19/90

SUBJECT: Previously Approved C.R.G. - Refinement
Windsor Corporate Park

To John L.
4/19/90 ucr

Please review the attached for conformance with current development regulations to allow for an extension of previously approved C.R.G. plan. Kindly return this cover letter with your comments and the attached print by 4/27/91.

SEE ATTACHED FOR COMMENTS

PAD
Attachment
cc: File

/ FOR H.O. REFERENCE
ALL COMMENTS WERE CHALLENGED. #84
TO BE ADDRESSED ON PLAN
PART OF #4 WAS MISSED THOUGH
SUBJECT: COUNTY REVIEW GROUP COMMENTS WHEN TO CONSIDER
IT AT THE HEARING.
FROM: ZONING OFFICE
PROJECT NAME: Windsor Corporate Park
LOCATION: N & S Lord Baltimore Drive,
N/S Dogwood Road and
E/S Rolling Road
PLAN: 4/25/89
REV.: *90-226-SPH*
REvised PLAN KEY:
(X) COMPLIANCE WITH COMMENT CHECKED
(O) NON-COMPLIANCE IS CIRCLED
(BA) BE ADVISED (NOT NECESSARY FOR C.R.G. APPROVAL, BUT MUST BE ADDRESSED PRIOR TO FINAL ZONING APPROVAL)
ADDITIONAL COMMENTS ADDED LAST BY PLAN DATE

COPY OF THESE COMMENTS TO BE HANDED ON 5/26/89
WE REQUEST THAT ALL COMMENTS BE ADDED TO THE PROVIDED PARCEL SITE PLAN. (TO BE REVIEWED ACCORDINGLY)
SUBMIT DATE: 6/1/89
PRE-CRG DATE: 5/23/89

The plan has been reviewed by this office for general compliance with the Baltimore County Zoning Regulations. The following comments identify obvious conflicts and details necessary in order to determine compliance with these regulations. When these standard and non-standard details and information (that has not been provided) is available or provided, it shall be the responsibility of the owner, developer, or developer's engineer to rectify any conflicts well in advance of the expected zoning approval. Because the R.T.A. regulations cannot be resolved via a zoning hearing, these particular comments must be resolved prior to C.R.G. approval:

1. R.T.A. - Include on the plan and clearly label all off-site sources of R.T.A. Dwellings must be labeled "existing dwelling" and all vacant lots must include the address. All lot and deed division lines that adjoin or are across the street from the subject property must be clearly labeled. All R.T.A. areas must be labeled on the required and applicable 300' or 250' radius dimensions on the SMALL LOTS OF RECORD (LESS THAN 2 ACRES) THAT CREATE A R.T.A. ON-SITE ARE SHOWN WITH THE REQUIRED 300 FEET ZONE LINE AREA. Clearly show R.T.A. and dimension all R.T.A. buffers. Provide the required and applicable R.T.A. buffers and remove any parking from the required R.T.A. buffer areas. The R.T.A. buffer cannot include a street R/W or required traffic sight line areas.

2. Access - Due to the availability of access on the North side with the extension of Lord Baltimore Drive through the M.L. zoned portion of the property, the additional access points on the South and Westermost portion of the property through the D.R.-5 zone would be governed by Zoning Policy BN-1-A.3.

OK A meeting with Carl Richards established that access is all public R/W and this comment is not

PLEASE PRINT CLEARLY
PETITIONER(S) SIGN-IN SHEET

NAME
Robert Hoffman
RANDY WARREN
Bill Brown
Pat Ciolkos
ADDRESS
210 Allegany Ave
2020 Lord Baltimore Dr. 21202
29 E. Susquehanna
307 Allegany Ave

WINDSOR CORPORATE PARK

Plan Refinement Comments
Revised Red-Lined Plan Comments: 8/16/90

The plan reviewed by Ann Nastarowicz (Deputy Zoning Commissioner) 8/16/90 has been approved as being within the spirit and intent of Zoning Hearing Case #90-226-SPH, subject to the requirement that a permanent black-lined plan be provided for the zoning hearing file. This plan must be certified by the engineer as showing and listing all changes on this red-lined plan with the understanding that no variances are required due to these changes.

Comply with the last paragraph of the previous comments.

[Signature]
JOHN L. LEWIS
PLANNING & ZONING ASSOCIATE III

JLL:scj
cc: Frank Fisher, Current Planning
Zoning File - #90-226-SPH
Waiver File /

REUSED COMMENTS PLAN DATE 8/13/90

PAN REV'D AND INCLUDED IN HEARING FILE. OK FOR ZONING
COMPLY WITH LAST PARAGRAPH OF COMMENTS FOR FINAL ZONING APPROVAL.

NOV. 9/5/90

CERTIFICATE OF POSTING
ZONING DEPARTMENT OF BALTIMORE COUNTY
Towson, Maryland

District 2nd
Posted for: Special Hearing
Petitioner: Leroy M. Merritt
Location of property: Windsor Corporate Park, N of Dogwood Road at
Edwards Avenue
Location of Sign: North side of Dogwood Road in front of subject
Property
Remarks:
Posted by: J. Robert Haines
Number of Signs: 1
Date of return: November 24, 1989

CERTIFICATE OF PUBLICATION

TOWSON, MD November 26, 1989
THIS IS TO CERTIFY, that the annexed advertisement was published in the OWINGS MILLS TIMES, a weekly newspaper printed and published in Towson, Baltimore County, Md., paper

OWINGS MILLS TIMES

S. Zebe Olson

Publisher

Baltimore County
Zoning Commissioner
Office of Planning & Zoning
Towson, Maryland 21204
(301) 887-3353

J. Robert Haines
Zoning Commissioner

DATE

Leroy M. Merritt
2020 Lord Baltimore Drive
Baltimore, Maryland 21207
Res Petition for Special Hearing
CASE NUMBER: 90-226-SPH
Windsor Corporate Park, N of Dogwood Road at Edwards Avenue
2nd Election District - 2nd Councilmanic
Petitioner(s): Leroy M. Merritt
HEARING: WEDNESDAY, DECEMBER 13, 1989 at 9:30 a.m.

Dear Sir:

Please be advised that \$ is due for advertising and posting of the above captioned property.

Baltimore County
Zoning Commissioner
County Office Building
111 W. Chesapeake Avenue
Towson, Maryland 21204

Account #001450
Name: Leroy M. Merritt
Number: Office 624
Address: 2020 Lord Baltimore Drive
City: Baltimore
State: MD
Zip: 21207
Phone: (301) 887-3353

Date: 12/12/89
12/12/89

M9000211
12/12/89

PUBLIC HEARING FEES
GPO - POSTING SIGNS / ADVERTISING \$ 111.09
TOTAL: \$ 111.09

LAST NAME OF OWNER: MERRITT
Comments:

Comments:

Comments:

receipt
624

Baltimore County
Zoning Commissioner
Office of Planning & Zoning
Towson, Maryland 21204
(301) 887-3353

November 15, 1989

NOTICE OF HEARING



Dennis F. Rasmussen
County Executive

The Zoning Commissioner of Baltimore County, by authority of the Zoning Act and Regulations of Baltimore County will hold a public hearing on the property identified herein in Room 105 of the County Office Building, located at 111 W. Chesapeake Avenue in Towson, Maryland as follows:

Petition for Special Hearing
CASE NUMBER: 90-226-SPH
Windsor Corporate Park, N of Dogwood Road at Edwards Avenue
2nd Election District - 2nd Councilmanic
Petitioner(s): Leroy M. Merritt
HEARING: WEDNESDAY, DECEMBER 13, 1989 at 9:30 a.m.

Special Hearing To approve a use permit for nesting in a residential zone.

In the event that this Petition is granted, a building permit may be issued within the thirty (30) day period after the hearing. The Zoning Commissioner will, however, entertain any request for a stay of the issuance of said permit during such period for good cause shown. Such request must be in writing and received in this office by the date of the hearing set above or presented at the hearing.

(If "Phase II" of the "SNOW EMERGENCY PLAN" is in effect in Baltimore County, on the above hearing date, the Hearing will be postponed. In the event of snow, telephone 887-3353 to confirm hearing date.)

J. Robert Haines
J. ROBERT HAINES
ZONING COMMISSIONER
BALTIMORE COUNTY, MARYLAND

RRHgs
cc: Leroy M. Merritt
John B. Howard, Esq.
File

BALTIMORE COUNTY ZONING PLANS ADVISORY COMMITTEE

November 29, 1989

COUNTY OFFICE BLDG.
111 W. Chesapeake Ave.
Towson, Maryland 21204

MEMBERS
Bureau of Engineering
Department of Traffic Engineering
State Roads Commission
Bureau of Fire Prevention
Health Department
Project Planning
Building Department
Board of Education
Zoning Administration
Industrial Development

John B. Howard, Esquire
210 Allegheny Avenue
Towson, MD 21204

RE: Item No. 84, Case No. 90-226-SPH.
Petitioner: Leroy M. Merritt
Petition for Special Hearing

Dear Mr. Howard:

The Zoning Plans Advisory Committee has reviewed the plans submitted with your referenced petition. The following comments are not intended to indicate the appropriateness of the zoning action requested, but to assure that all parties are made aware of plans or problems with regard to the development plans that may have a bearing on this case. Director of Planning may file a written report with the Zoning Commissioner with recommendations as to the suitability of the requested zoning.

Enclosed are all comments submitted from the members of the Committee at the time that you referred or request information on your petition. If similar comments from the remaining members are received, I will forward them to you. Otherwise, any comment that is not informative will be placed in the hearing file. This petition was accepted for filing on the date of the enclosed filing certificate and a hearing scheduled accordingly.

IT WOULD BE APPRECIATED IF YOU WOULD RETURN YOUR WRITTEN COMMENTS TO MY OFFICE, ATTENTION JULIE WINIARSKI. IF YOU HAVE ANY QUESTIONS REGARDING THIS, PLEASE CONTACT HER AT 887-3391.

Very truly yours,

James E. Dyer
JAMES E. DYER
Chairman
Zoning Plans Advisory Committee

JED:jw

Enclosures

cc: Mr. Leroy M. Merritt:
2066 Lord Baltimore Drive
Baltimore, MD 21207

Baltimore County
Zoning Commissioner
Office of Planning & Zoning
Towson, Maryland 21204
(301) 887-3333

J. Robert Haines
Zoning Commissioner

Dennis F. Rasmussen
County Executive



Dec 13

BALTIMORE COUNTY, MARYLAND
INTER-OFFICE CORRESPONDENCE

TO: J. Robert Haines
Zoning Commissioner
FROM: Pat Keller, Deputy Director
Office of Planning and Zoning
SUBJECT: Leroy Merritt, Item 84
Zoning Petition No. 90-226

DATE: December 5, 1989

The Petitioner requests a special hearing for use permit for parking in a residential zone pursuant to Section 409.4 of the Baltimore County Zoning Regulations.

The area subject to this petition is located adjacent to MLR zoned land. Section 250.6 of the Baltimore County Zoning Regulations states in part, "off-street parking and loading areas shall be in accordance with the requirements of Section 409, but no parking is permitted within 25 ft. of any residential zone boundary." The intent of this regulation is to provide a buffer to residential areas from industrial uses. In fact, the park strip was purposely applied to this site to effectively buffer the adjacent residential community. Industrial/office intrusion into the community is not desired and an effort was made not to negatively impact the residentially zoned land.

Based on the information provided, and the analysis conducted, staff recommends denial of the Petitioner's request.

If there should be any further questions or if this office can provide additional information, please contact Jeffrey Long in the Office of Planning at 887-3211.

PK/JL/cmm

12/11/89 called office Cullen for Pky

DEC 06 1989

RECEIVED
SEP 14 1989

ZONING OFFICE



September 12, 1989

Dennis F. Rasmussen
County Executive

Baltimore County
Department of Public Works
Bureau of Traffic Engineering
Courts Building, Suite 405
Towson, Maryland 21204
(301) 887-3354

Mr. J. Robert Haines
Zoning Commissioner
County Office Building
Towson, MD 21204

Dear Mr. Haines:

The Bureau of Traffic Engineering has no comments for items number 83, 84, 85, 86, 88, 89, 90, 92, and 93.

Very truly yours,
Michael S. Flanigan
Michael S. Flanigan

SEP 19 1989

Baltimore County
Fire Department
200 York Road
Towson, Maryland 21204-2536
(301) 887-4500

Paul H. Rehme
Chief

September 14, 1989



Dennis F. Rasmussen
County Executive


J. Robert Haines
Zoning Commissioner
Office of Planning and Zoning
Baltimore County Office Building
Towson, MD 21204


RE: Property Owner: LEROY M. MERRITT
Location: WINDSOR CORPORATE PARK, N OF
DOGWOOD ROAD AT EDWARDS AVENUE
Item No.: 84 Zoning Agenda: AUGUST 19, 1989

Gentlemen:
Pursuant to your request, the referenced property has been surveyed by this Bureau and the comments below are applicable and required to be corrected or incorporated into the final plan for the property.

7. The Fire Prevention Bureau has no comments at this time.

REVIEWER: *John H. Brady*
Noted and Approved
Planning Group
Special Inspection Division
FIRE PREVENTION BUREAU

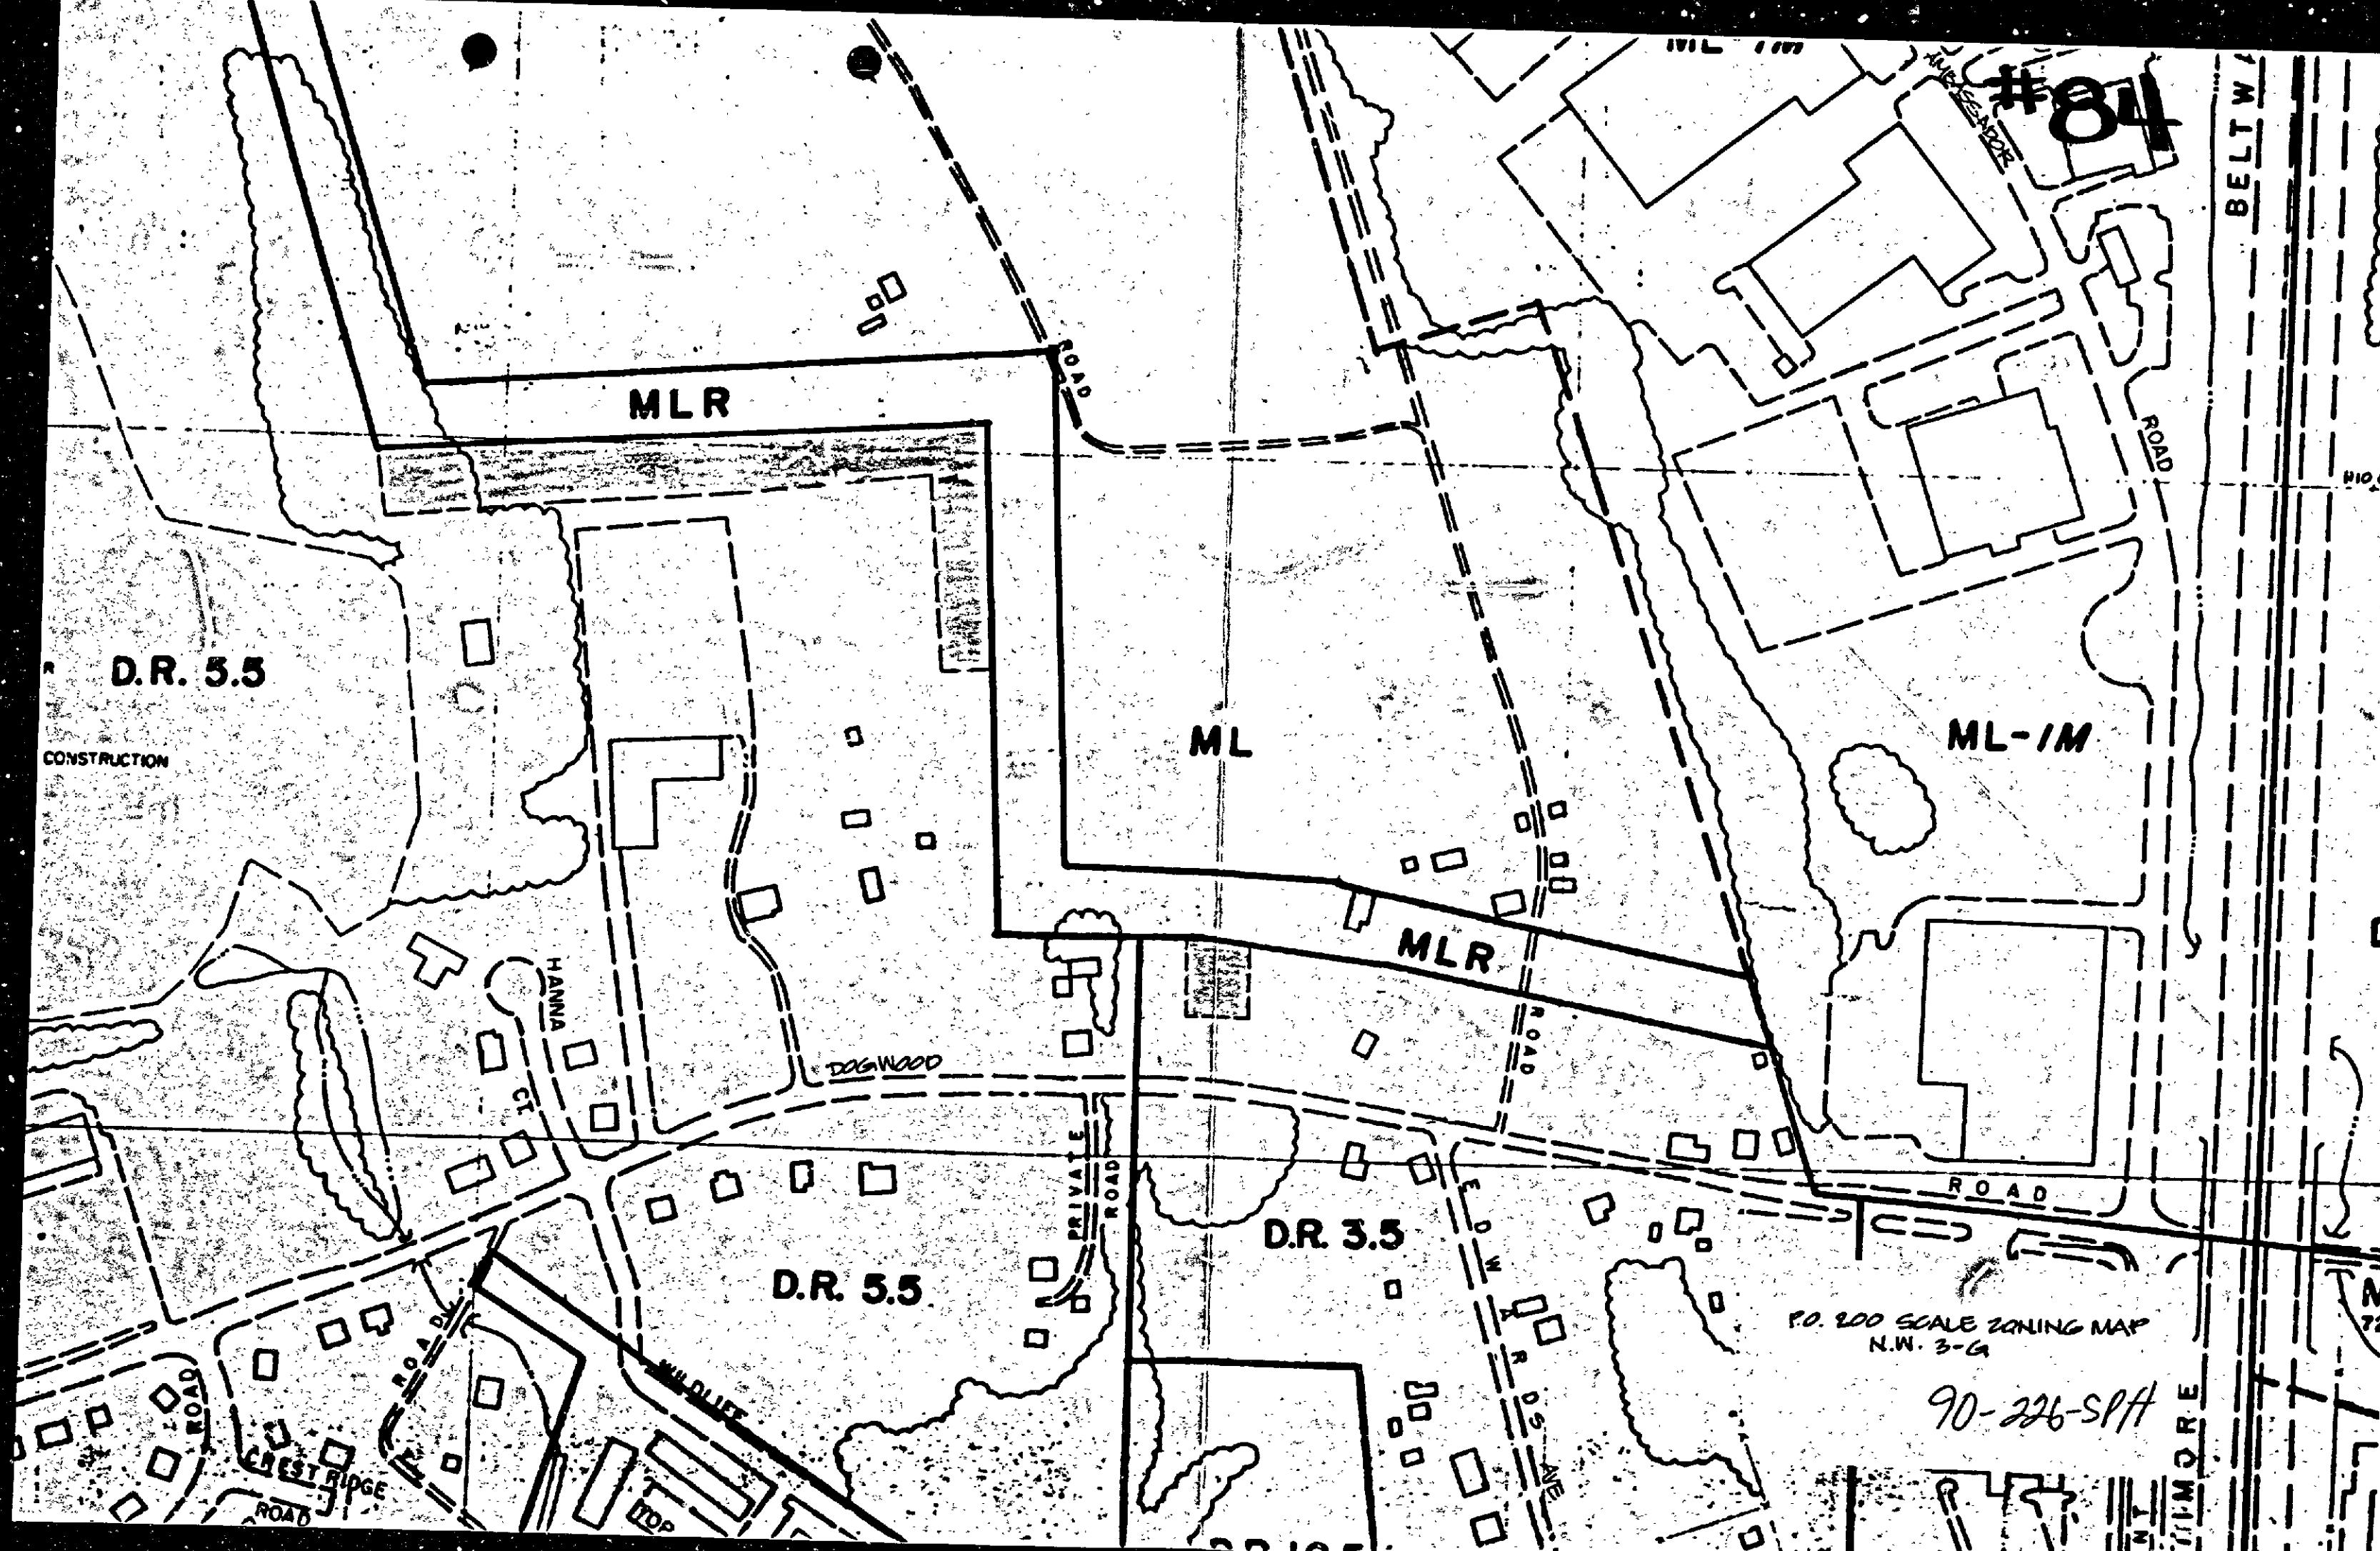


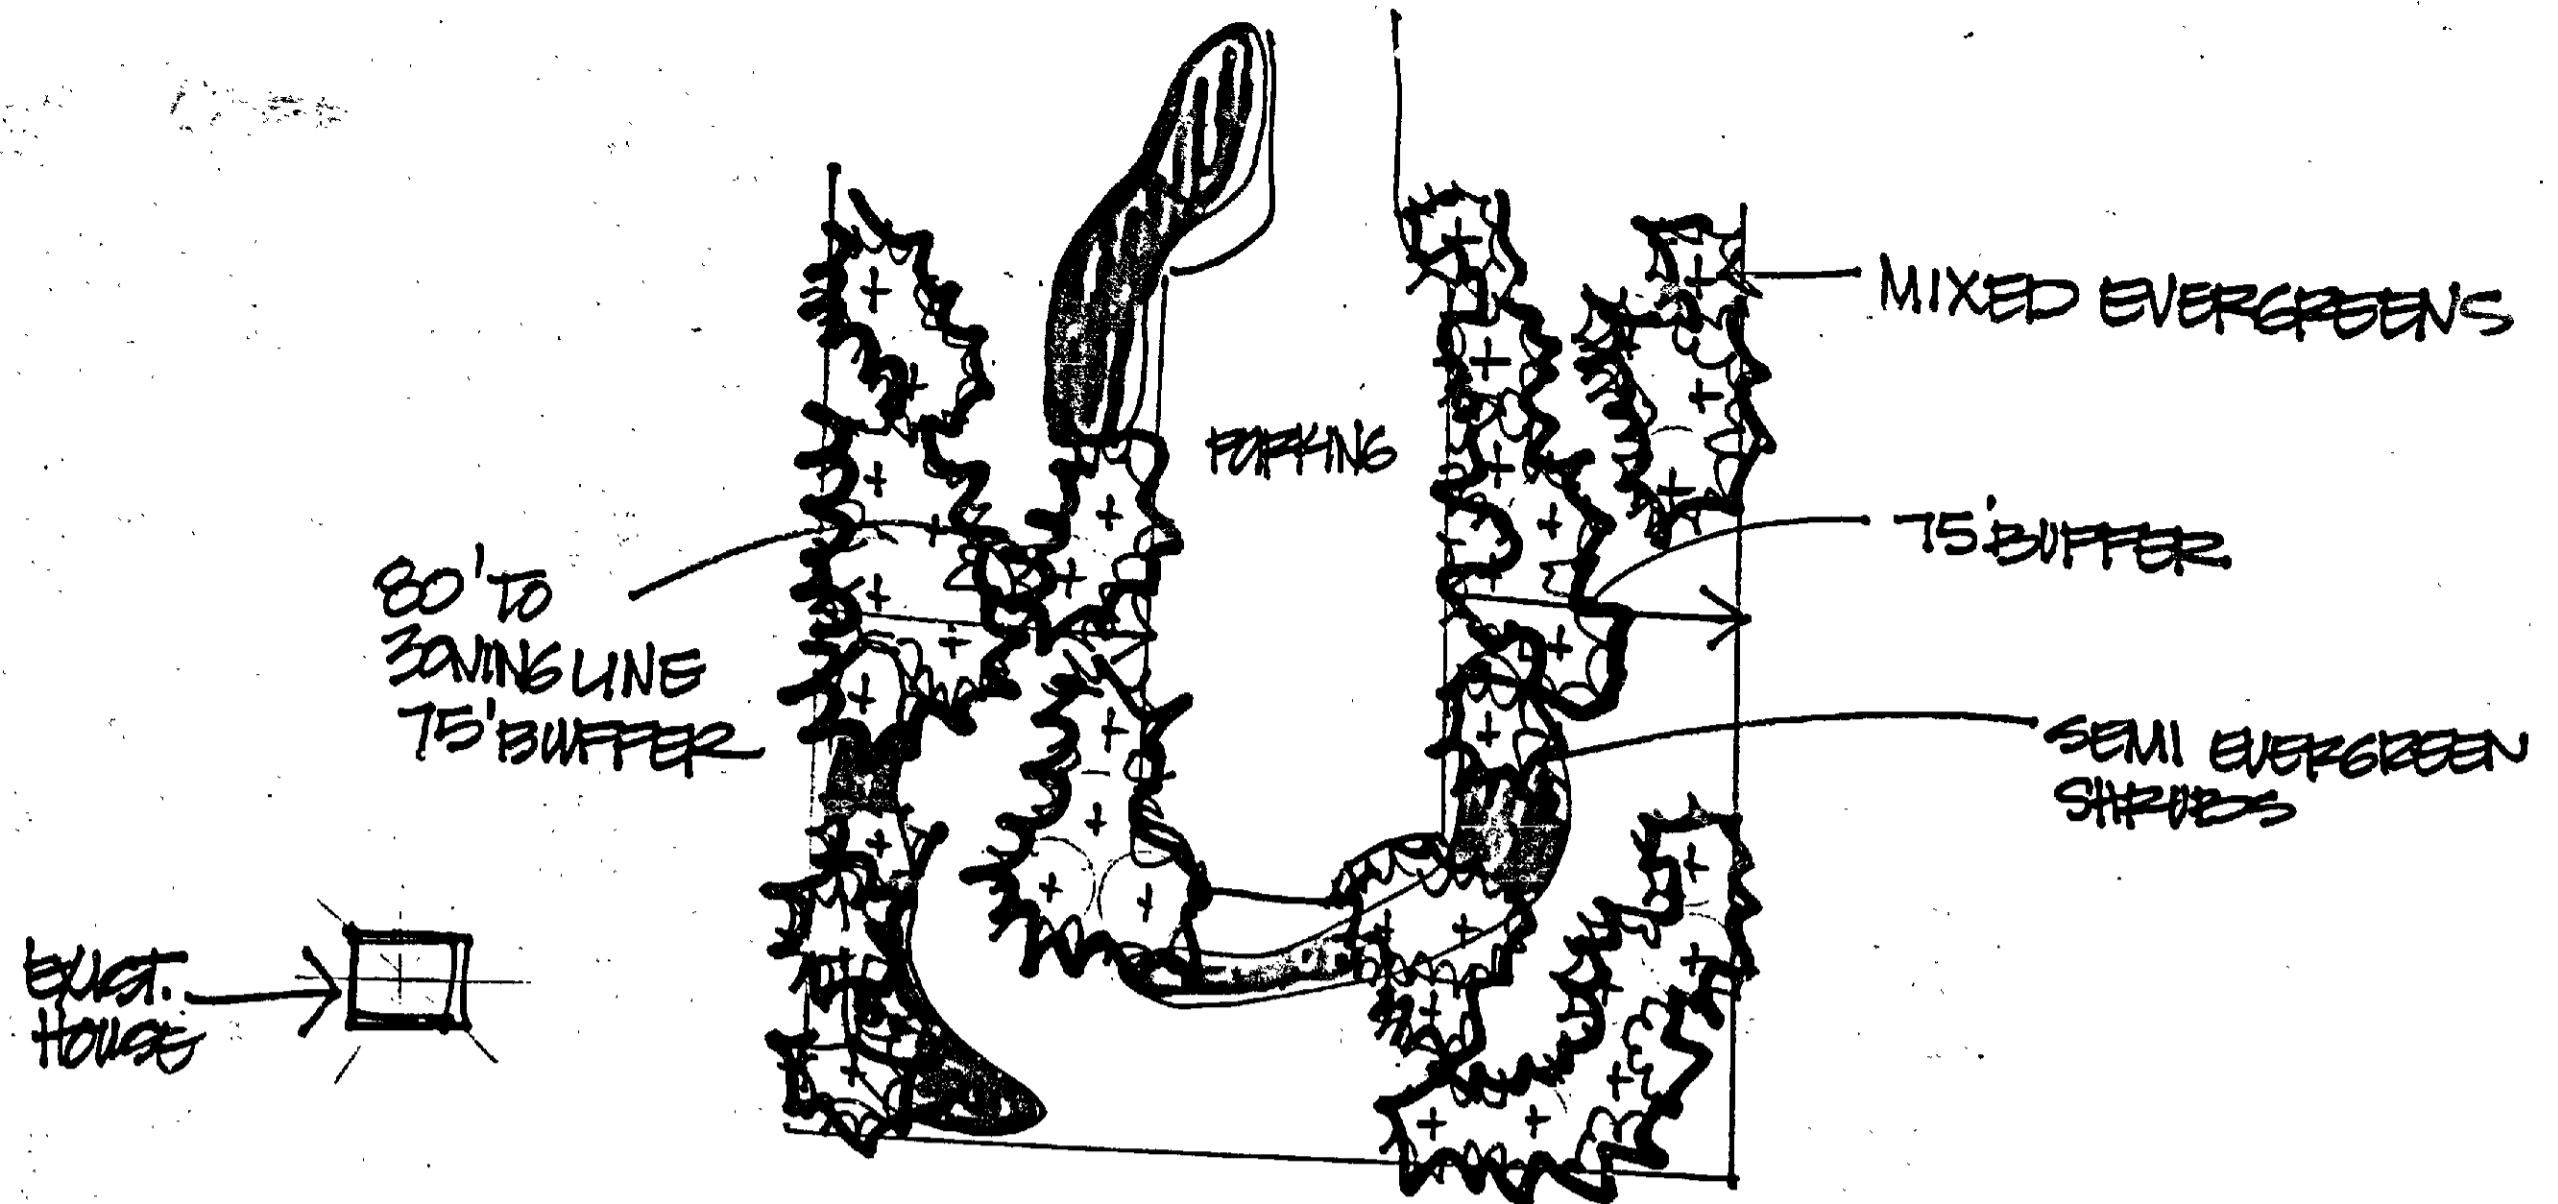

PLANTING - RESIDENTIAL TRANSITION


NO. SCALE: WILLIAM F. KIRWIN. LANDSCAPE ARCHITECTS

PETITIONER'S
EXHIBIT 2B

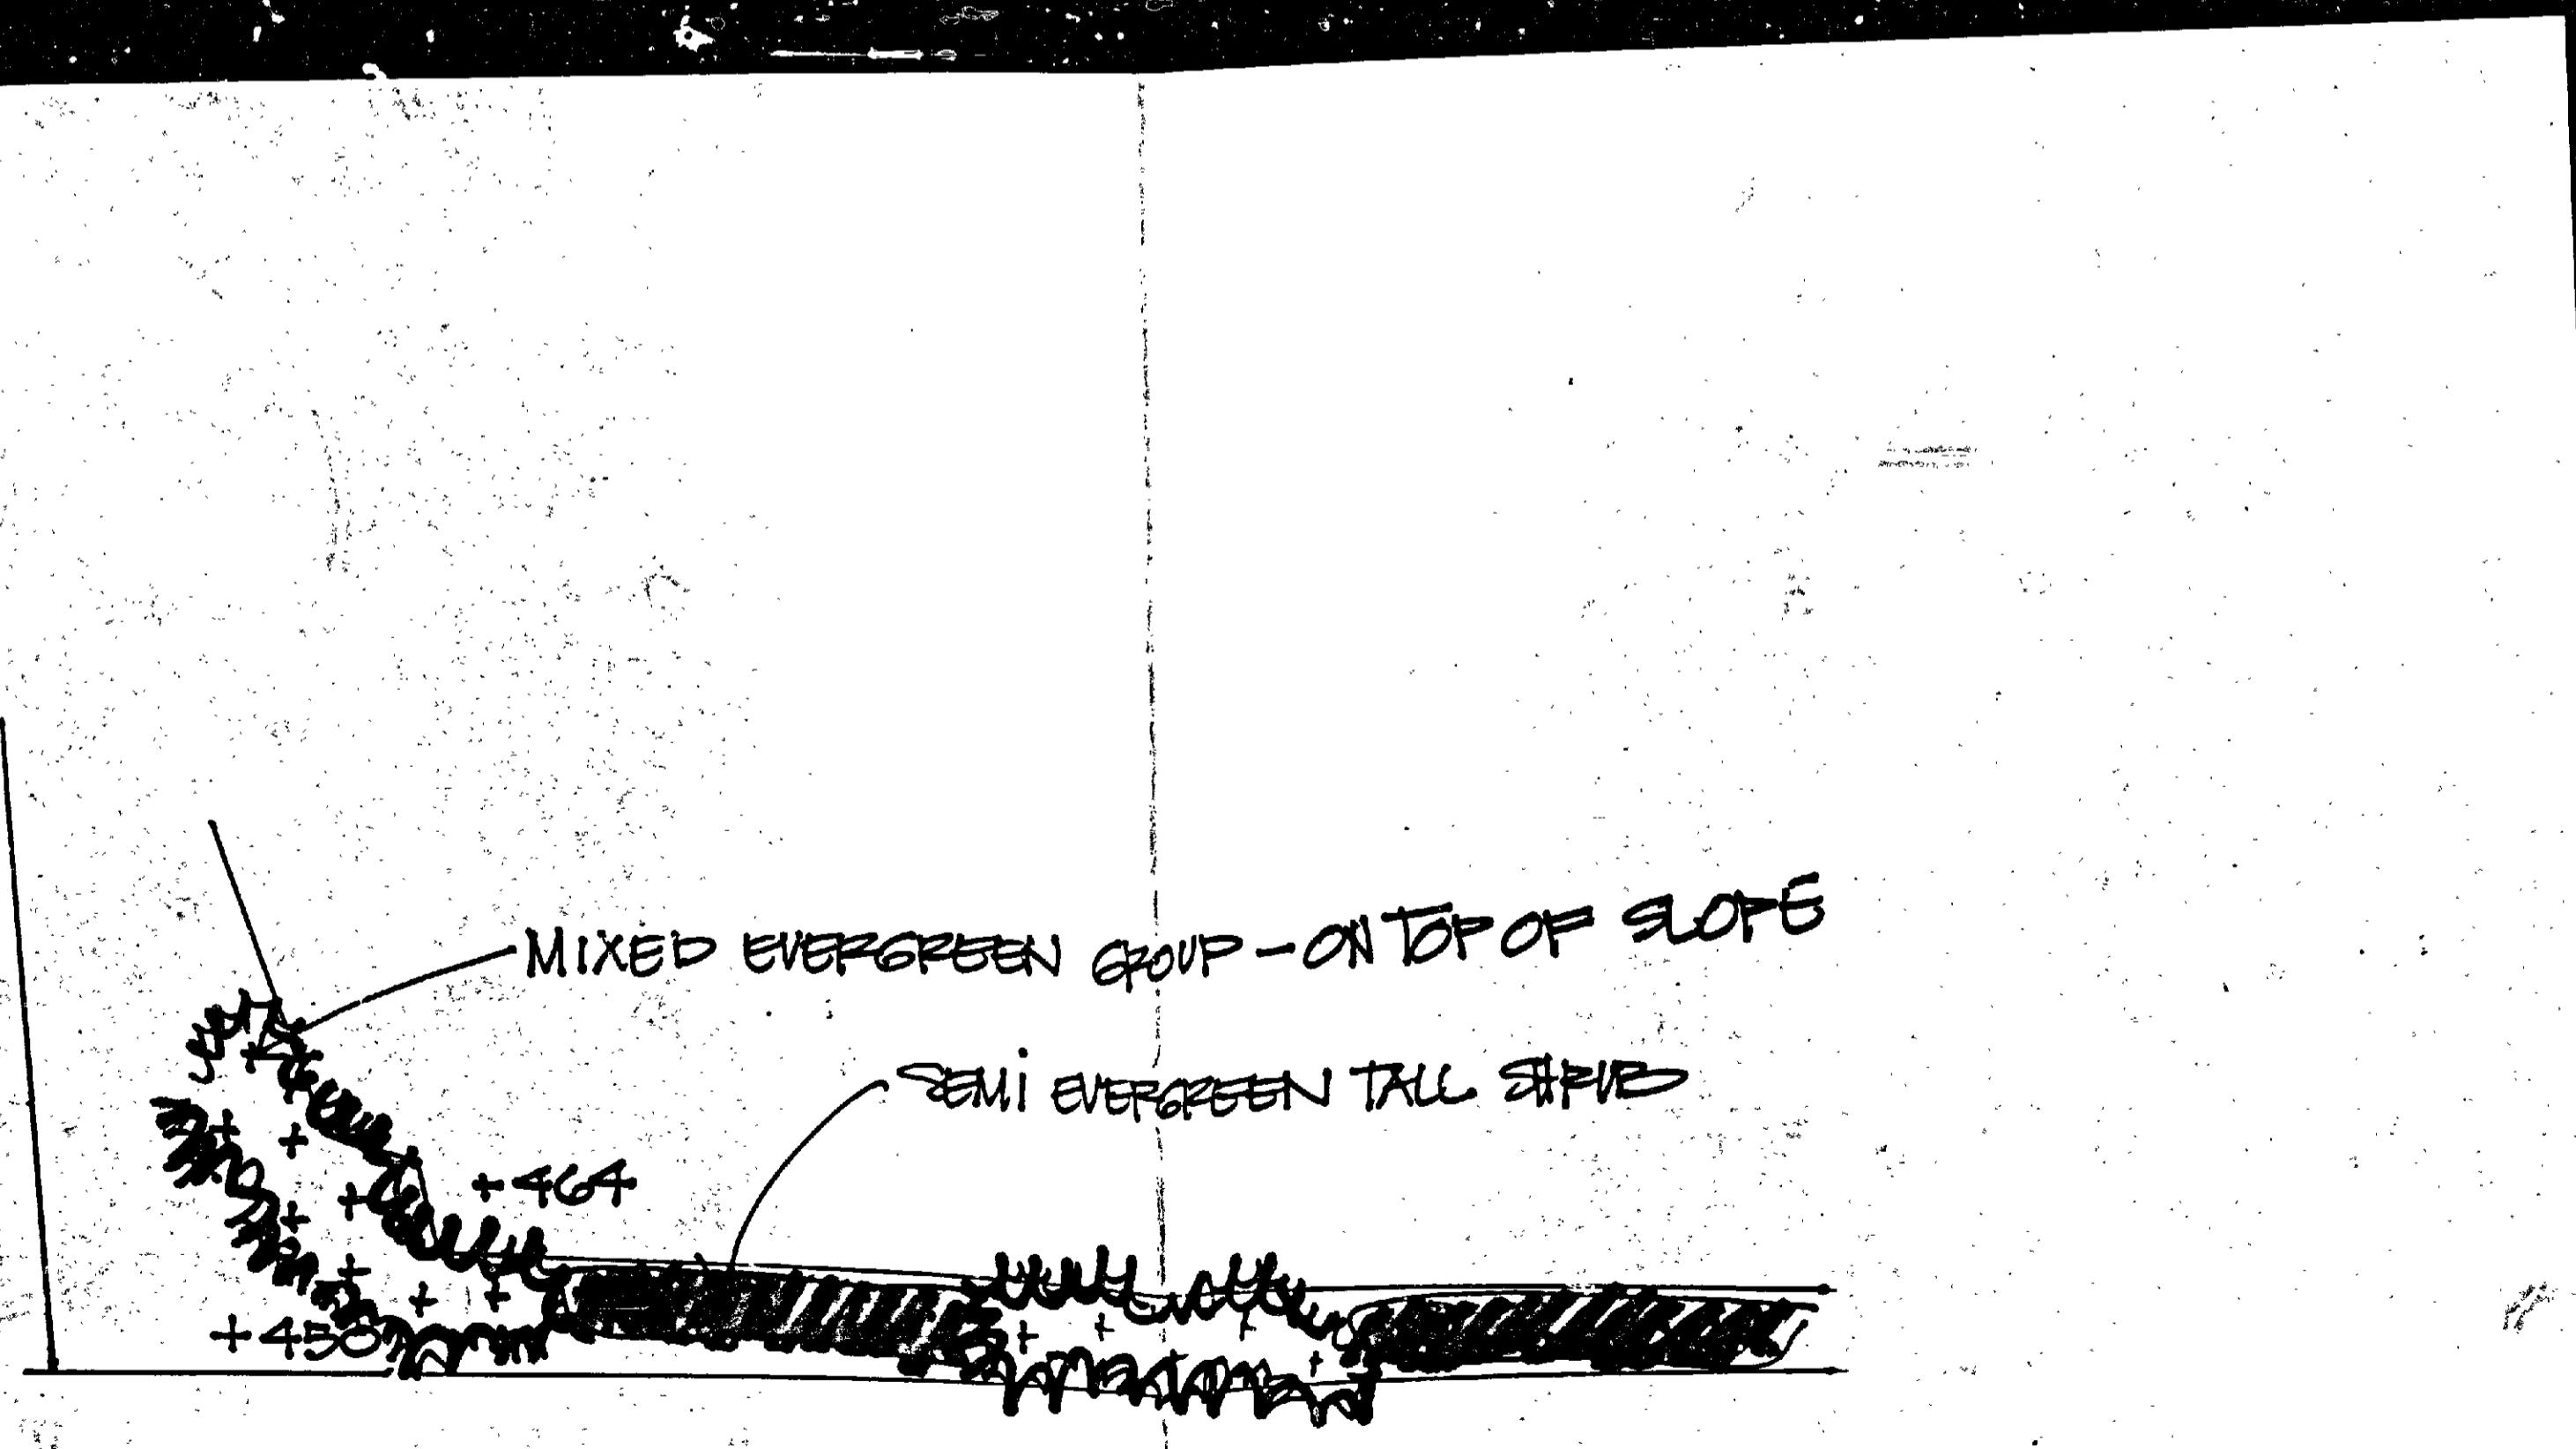

PLANTING - PARKING IN RESIDENTIAL ZONE
NO. SCALE: WILLIAM F. KIRWIN INC. LANDSCAPE ARCHITECTS.

PETITIONER'S
EXHIBIT 2A

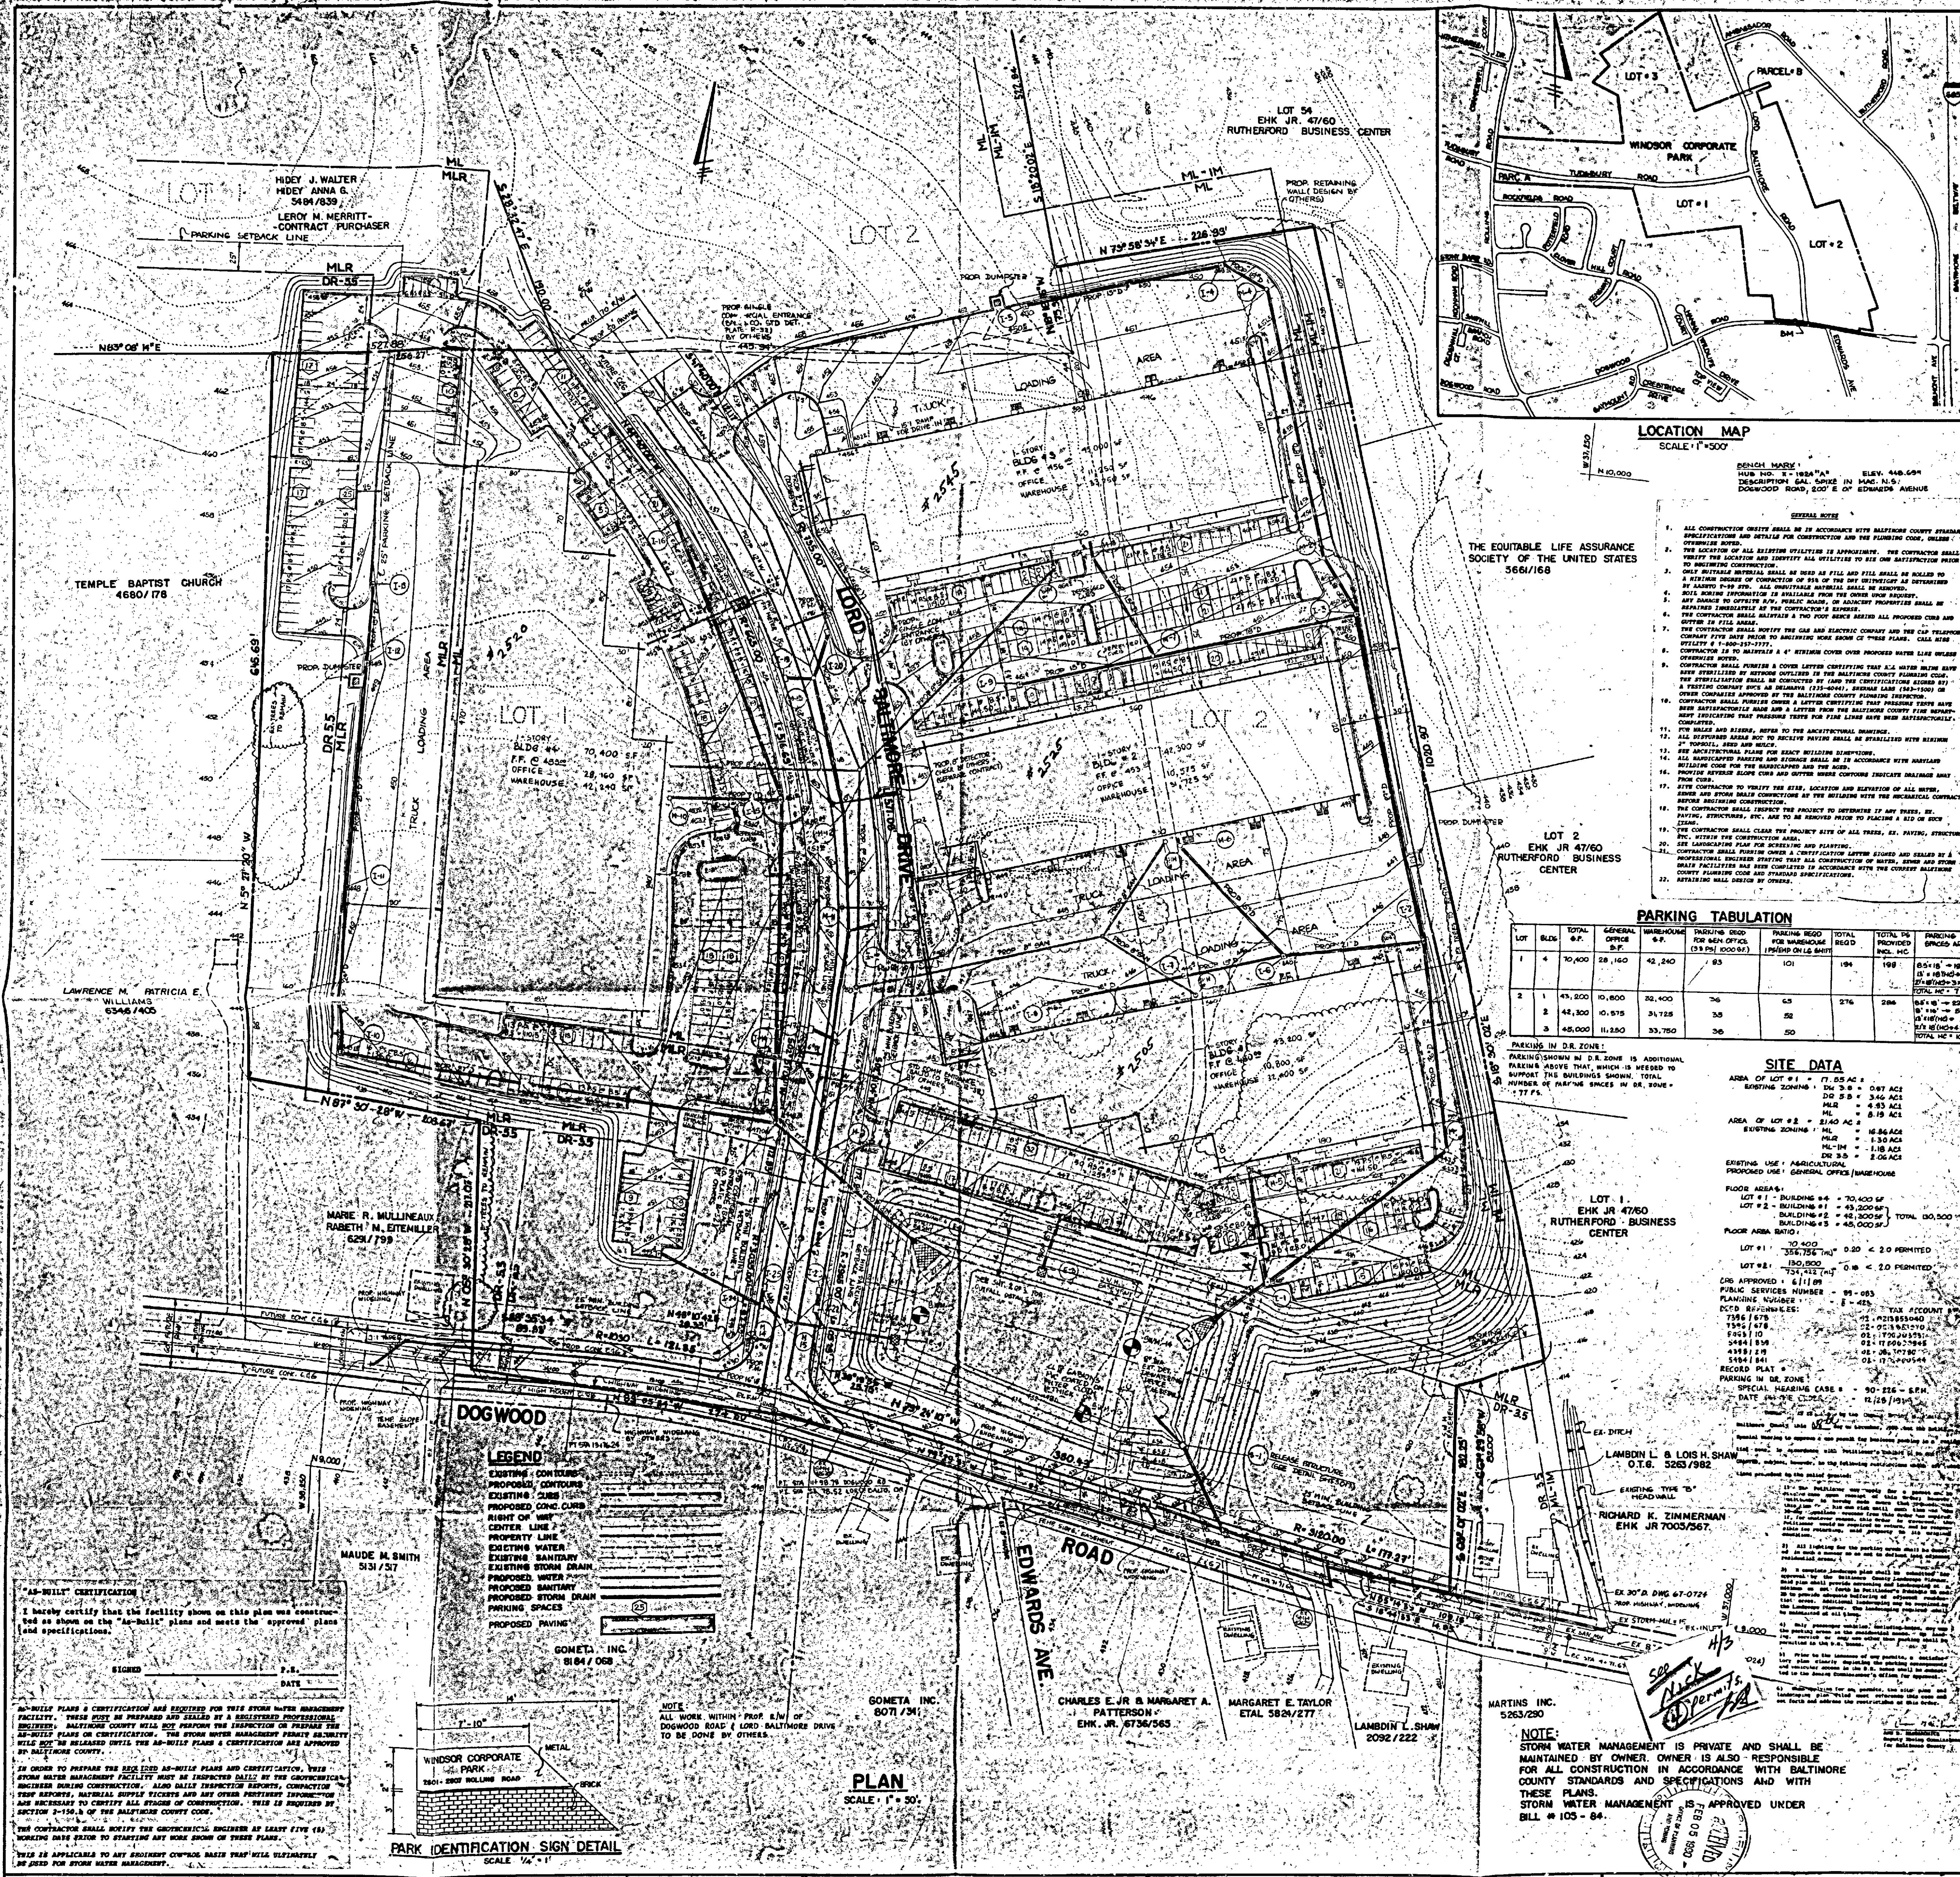

GEORGE WILLIAM STEPHENS, JR.
AND ASSOCIATES, INC.

CIVIL ENGINEERS & LAND SURVEYORS



ENGINEER'S CERTIFICATION
I HEREBY CERTIFY THAT THIS PLAN HAS BEEN PREPARED BY ME OR
UNDER MY SUPERVISION AND MEETS THE MINIMUM STANDARDS OF THE
BALTIMORE COUNTY DEPARTMENT OF PUBLIC WORKS AND THE BALTIMORE
COUNTY SOIL CONSERVATION DISTRICT

CHIEF PLANNER
MERRITT
2066 Lord Baltimore Drive

DEVELOPER'S/LAND OWNER'S CERTIFICATION
I HEREBY CERTIFY THAT ALL PROPOSED WORK, SHOWN ON THESE
CONSTRUCTION PLANS, IS AND WILL BE APPROVED, CONDUCTED,
TESTED, REPORTED, MATERIAL SUPPLY VICTIMS AND ANY OTHER PERTINENT INFORMATION
AS NECESSARY TO CERTIFY ALL STAGES OF CONSTRUCTION. THIS IS PROVIDED BY
SECTION 3-150-B OF THE BALTIMORE COUNTY CODE.

THE CONTRACTOR SHALL NOTIFY THE GEOGRAPHICAL ENGINEER AT LEAST FIVE (5)
WORKING DAYS PRIOR TO STARTING ANY WORK SHOWN ON THESE PLANS.

THIS IS APPLICABLE TO THE ENGINEER-CERTIFIED PLANS WHICH WILL ULTIMATELY
BE USED FOR STORM WATER MANAGEMENT.

SITE PLAN AND STORM WATER MANAGEMENT
FOR
WINDSOR CORPORATE PARK





BALTIMORE COUNTY
OFFICE OF PLANNING AND ZONING
PHOTOGRAPHIC MAP

SCALE
1" = 200'
DATE
OF
PHOTOGRAPHY
JANUARY
1986
LOCATION
SHEET
PETITIONER'S
EXHIBIT 3-G